


- Extend service lateral to property line. The location will be determined by the Engineer to facilitate plumbing connections. Complete the symbol for inclusion into record drawings. Information required as follows:
- 1 - Distance, in feet, from center of downstream manhole
  - 2 - Length, in feet, of lateral from plug to centerline of main.
  - 3 - Depth, in inches, of end plug from surface.

- MECHANICAL/ELECTRICAL NOTES:  
SEWER NOTES IN CLOUD**
1. PROVIDE TRANSFORMER PADS & WALL AS REQUIRED BY KENTUCKY UTILITIES COMPANY.
  2. SIZE 4" UNDERGROUND ELECTRICAL CONDUITS ONE TO STUB UP IN EACH TRANSFORMER WITH ONE SPICE. CONTRACTOR TO PROVIDE CONDUIT FROM POLES TO PADS. KENTUCKY UTILITIES TO PROVIDE CONDUCTORS & MAKE CONNECTIONS TO TRANSFORMERS.
  3. SECONDARY CONDUIT & CONDUCTORS TO MAIN DISTRIBUTION PANELS SUPPLIED BY CONTRACTOR. KENTUCKY UTILITIES TO MAKE CONNECTIONS TO TRANSFORMERS.
  4. OUTDOOR LIGHT POLE AND FIXTURE.
  5. PROVIDE TWO NATURAL GAS REGULATORS, ONE SET AT 5 PSI RATED @ 30,000,000 BTU/H AND ONE SET AT 2 PSI RATED @ 4,000,000 BTU/H.
  6. 4" STUB OUT, ELBOW UP AND PROVIDE EXTENSION TO 3" ABOVE GRADE AND CAP FOR FUTURE BUILDING. MUST BE EXTENDED BEYOND BACK OF CURB.
  7. 4" HOUSE SEWER FOR GUARD SHACK.
  8. DOMESTIC WATER FROM BUILDING (OUTLET SIDE OF REPP) TO GUARD SHACK.
  9. PROVIDE FREEZE PROOF YARD HYDRANT.
  10. REFER TO TIME CLOCK/PHOTO CELL SCHEMATIC ON SHEET NO. UFL-12-E-001A.
  11. INSTALL OR OUTLET AND 1/2 HP SUMP PUMP IN SPRINKLER PIT. DISCHARGE PUMP TO OUTSIDE. INSTALL WATER PROOF ENCLOSED ELECTRIC LIGHT WITH 25 WATT SCREW IN FLUORESCENT AND WATER PROOF WALL SWITCH.
  12. CIRCUIT FOR ILLUMINATED SIGN.
  13. POWER THE GUARD SHACK.
  14. CONDUIT FOR TAMPER SWITCH.
  15. NATURAL GAS METER BY CITY OF ELIZABETHTOWN GAS COMPANY. 35 PSI RATED @500,000,000 BTU.
  16. NATURAL GAS DISTRIBUTION PIPING.
  17. NATURAL GAS SHUT-OFF VALVE & CAPPED LINE FOR FUTURE BUILDINGS.
  18. WATER METER VAULT.
  19. SPRINKLER VAULT.
  20. 4" PVC CONDUITS, STUB UP IN DATA ROOM AND EXTEND 10' ACROSS STREET, STUB UP AND CAP.
  21. 2" PVC CONDUITS, STUB UP IN CONTROL ROOM AND EXTEND 10' ACROSS STREET, STUB UP AND CAP.

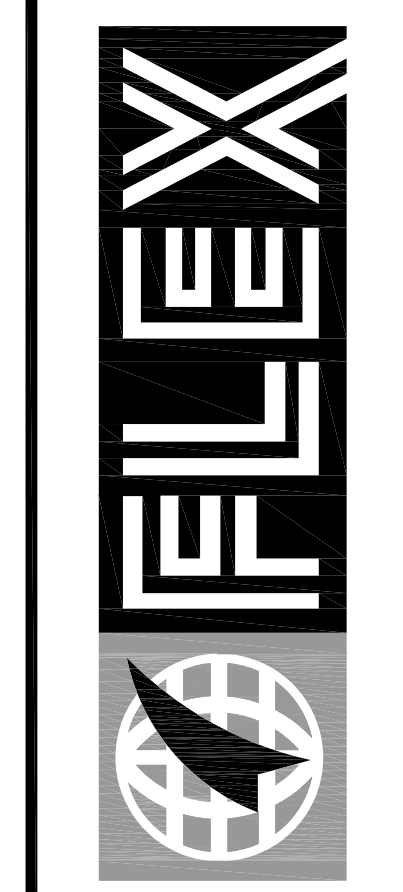

**FLEXFILMS, U.S.A., LLC**  
1221 NORTH BLACK BRANCH ROAD  
ELIZABETHTOWN, KENTUCKY 42702

DATE	BY	REVISION
10-2011	DMW	DATE
1-2012	DMW	DATE
		POST BID REVISIONS
		POST BID REVISIONS

PROJECT NO. 2064-25  
DESIGNED BY E.G.M.  
DRAWN BY J.R.M.  
CHECKED BY E.G.M.  
REVIEWED BY E.G.M.  
DATE JULY 2011  
SCALE AS SHOWN

**nsc**  
OF KENTUCKY, INC.  
Engineers  
Architects  
Planners

624 Wallington Way  
Lexington, KY 40503  
www.nscinc.com  
Phone: (859)223-5664  
Fax: (859)223-2607

**DRAWING NO.**  
**UFL-L12**  
**C111**

**SANITARY SEWER - PLAN**

JAN 24 KA 2064-25 FLEX FILM - ELIZABETHTOWN TJ PATTERSON INDUSTRIAL PARK SAN SEWER C-111 SANITARY SEWER.DWG